


RECEIVED
JUL 21 2006
DIV. OF OIL, GAS & MINING

FILE IN: Expandable 07/18/2006
Refer to Record No. 0032
in 0070038 2006. 12/15/2006
for additional information

LEGEND

- DISTURBED AREA BOUNDARY
- ACCESS ROAD
- TRAIL
- HIGHWAY
- POWERLINE (MAJOR ONLY)
- FENCE LINE
- STREAM, DRAINAGE, RIVER
- (WCRD-1) WILLOW CREEK RECLAMATION DIVERSION
- RETAINED PRE-SMCRA HIGHWALL
- RETAINED PRE-SMCRA OUTSLOPE
- DRAINAGE DITCH
- CULVERT
- INDUSTRIAL POSTMINING LAND USE BOUNDARY (96.4 ACRES)
- CRU OWNERSHIP BOUNDARY (SEE MAP 21C-AB FOR ENTIRE OWNERSHIP AREA)

NOTES:

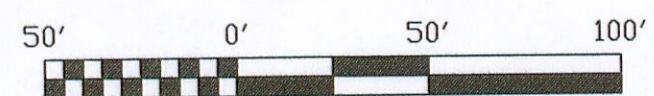

XREF'S

G:\UC709\23\DWG\BASE-WCREEK.DWG
G:\UC709\23\DWG\BASE-20CUT.DWG
EarthFax Engineering, Inc. Engineers/Scientists

REVISION/HISTORY

BY	DATE	DESCRIPTION
JP	02-03	ADD ALTERNATIVE RECLAMATION DESIGN
JP	08-03	RESPOND TO DIVISION COMMENTS
LDJ	03-06	AS-BUILT

PLATEAU MINING CORPORATION

847 NW HIGHWAY 191 HELPER, UTAH 84526
PHONE: (435) 472-0475

WILLOW CREEK MINE
AS-BUILT TOPOGRAPHY AND
DRAINAGE STRUCTURES
LOCATION MAP

DRAWN BY: SWF DATE: DEC 2000

CHECKED BY: LDJ DATE: 12-15-00

DRAWING NO. G:\UC709\23\DWG\MAP21D-AB.DWG\01-16-05

MAP 21D - AB